
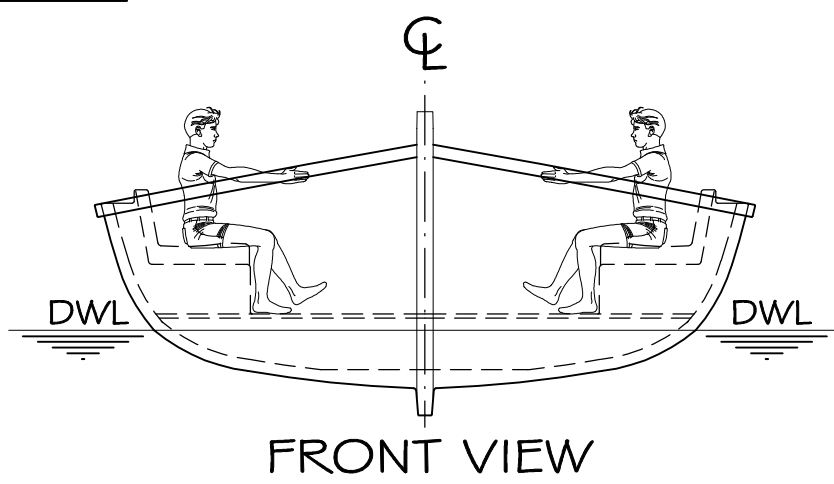
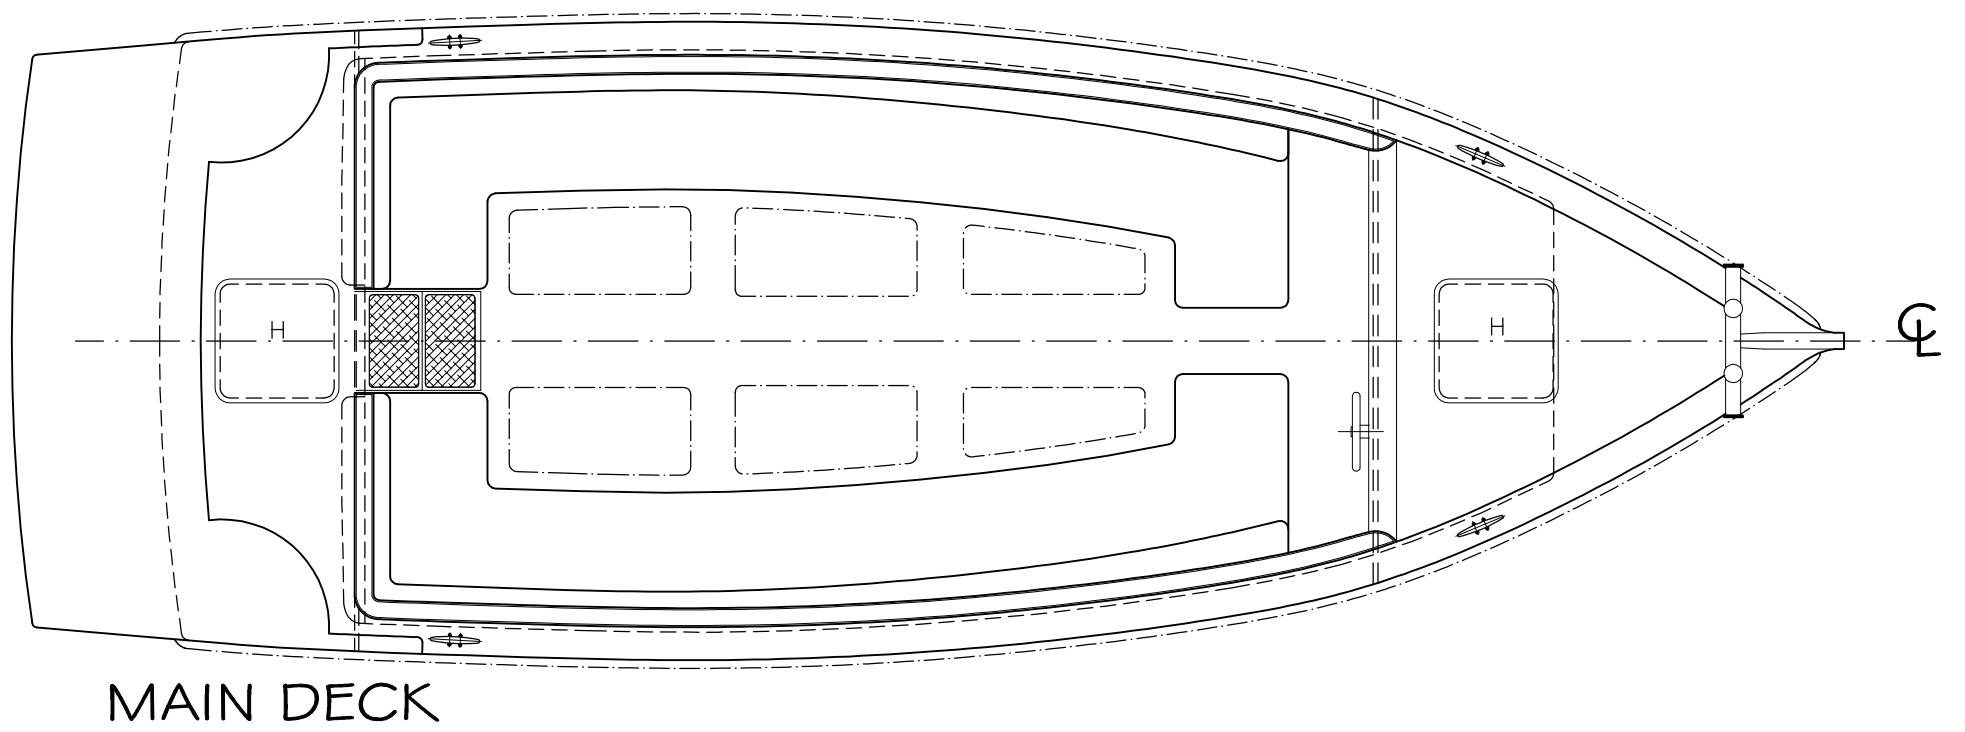
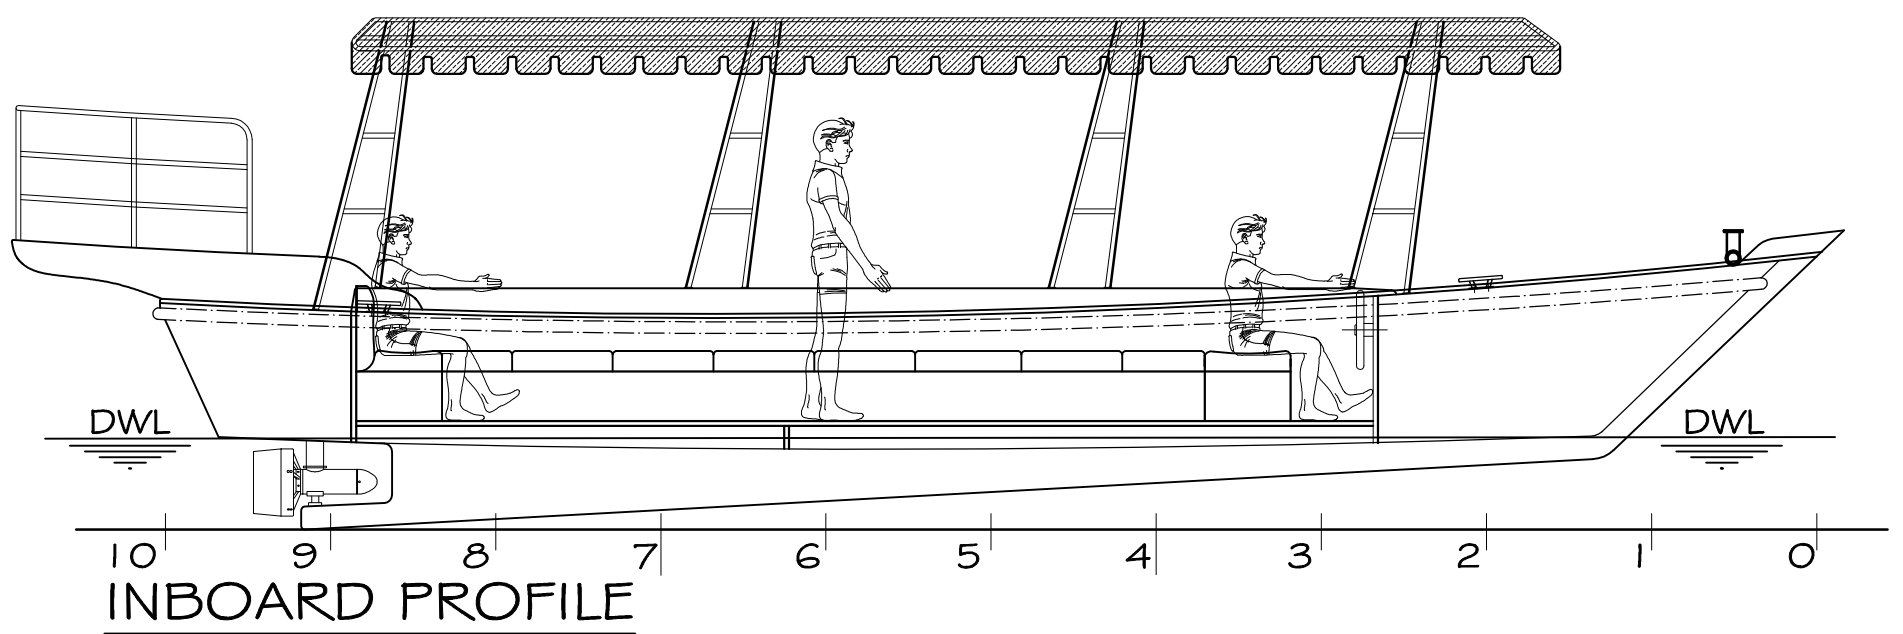


PARTICULARS

L. O. A	11.00 M
L. W. L	8.53 M
BEAM (mid)	3.84 M
DESIGN DRAFT	0.60 M

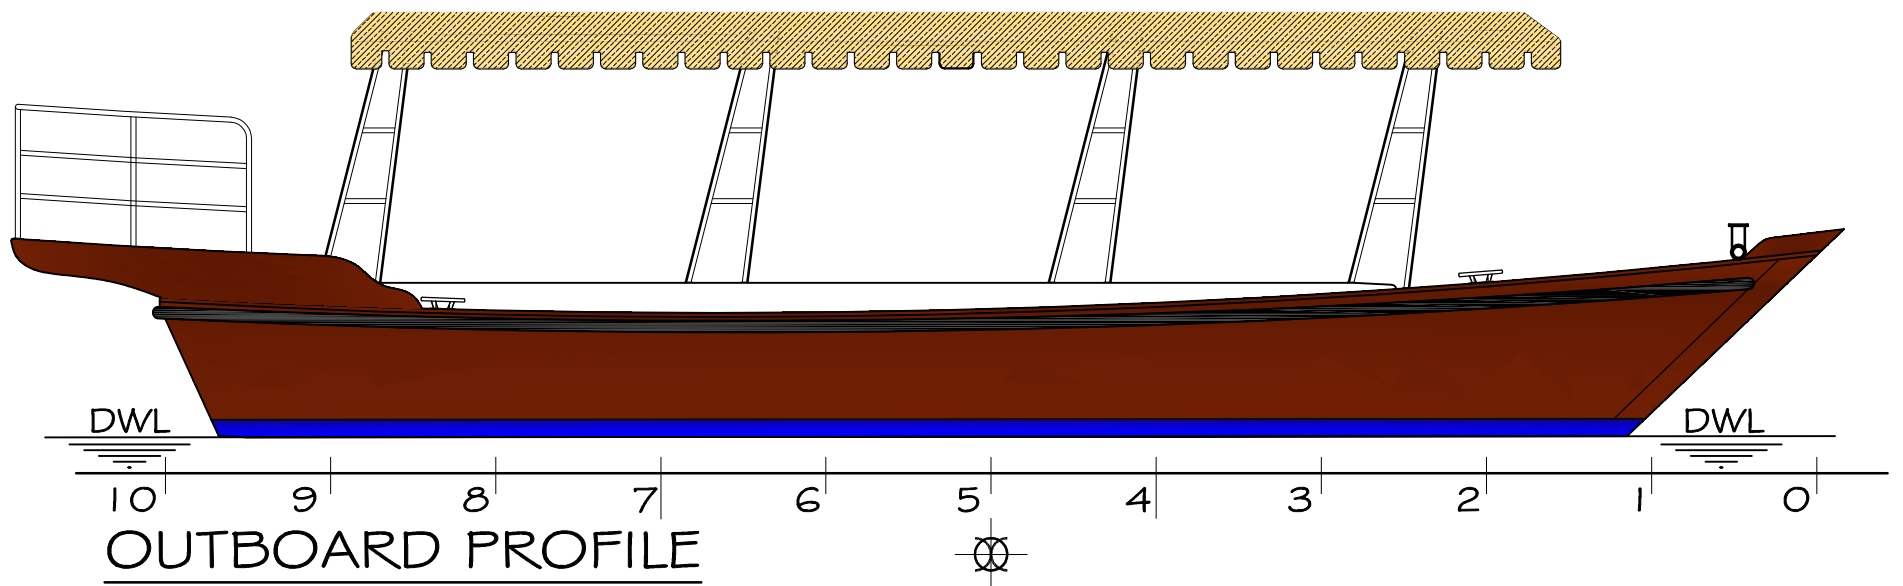

		PROJECT: IOM ABRA BOAT	
GENERAL ARRANGEMENT		SCALE: 1:25	
AS BUILT	1	12.02.17	TCA
FIRST ISSUE	0	22.08.16	JZE
REVISIONS	NO	DATE	DRN
			CHKD
			APP
			DATE
			BY
			NO
			OF
			TOTAL